


MANHOLE DETAILS

PIT NUMBER	LID LEVEL	OUTLET LEVEL	INLET LEVEL/S
8/12	17.66	16.31	16.78 N, 16.33 S
9/12	18.5	17.28	17.33 E, 17.33 S
10/12	18.56	17.78	17.82
11/12	20.75	19.22	19.27
1/13	19.56	18.33	18.37
1/14	18.56	17.78	17.82


TABLE FORMAT FOR MANHOLE LEVEL DETAILS PREFERRED.
 (LEVELS ON FACE OF PLAN AN ALTERNATE OPTION ONLY IF
 PLAN IS OPEN ENOUGH TO FACILITATE CLEAR INTERPOLATION
 SEE SETOUT OF TEXT AS SHOWN ON THIS SAMPLE PLAN)

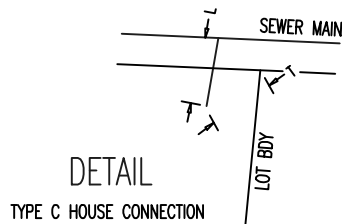

LEGEND

- Sewers
- - - - Kerb and channel

This drawing is indicative of plan presentation format only.

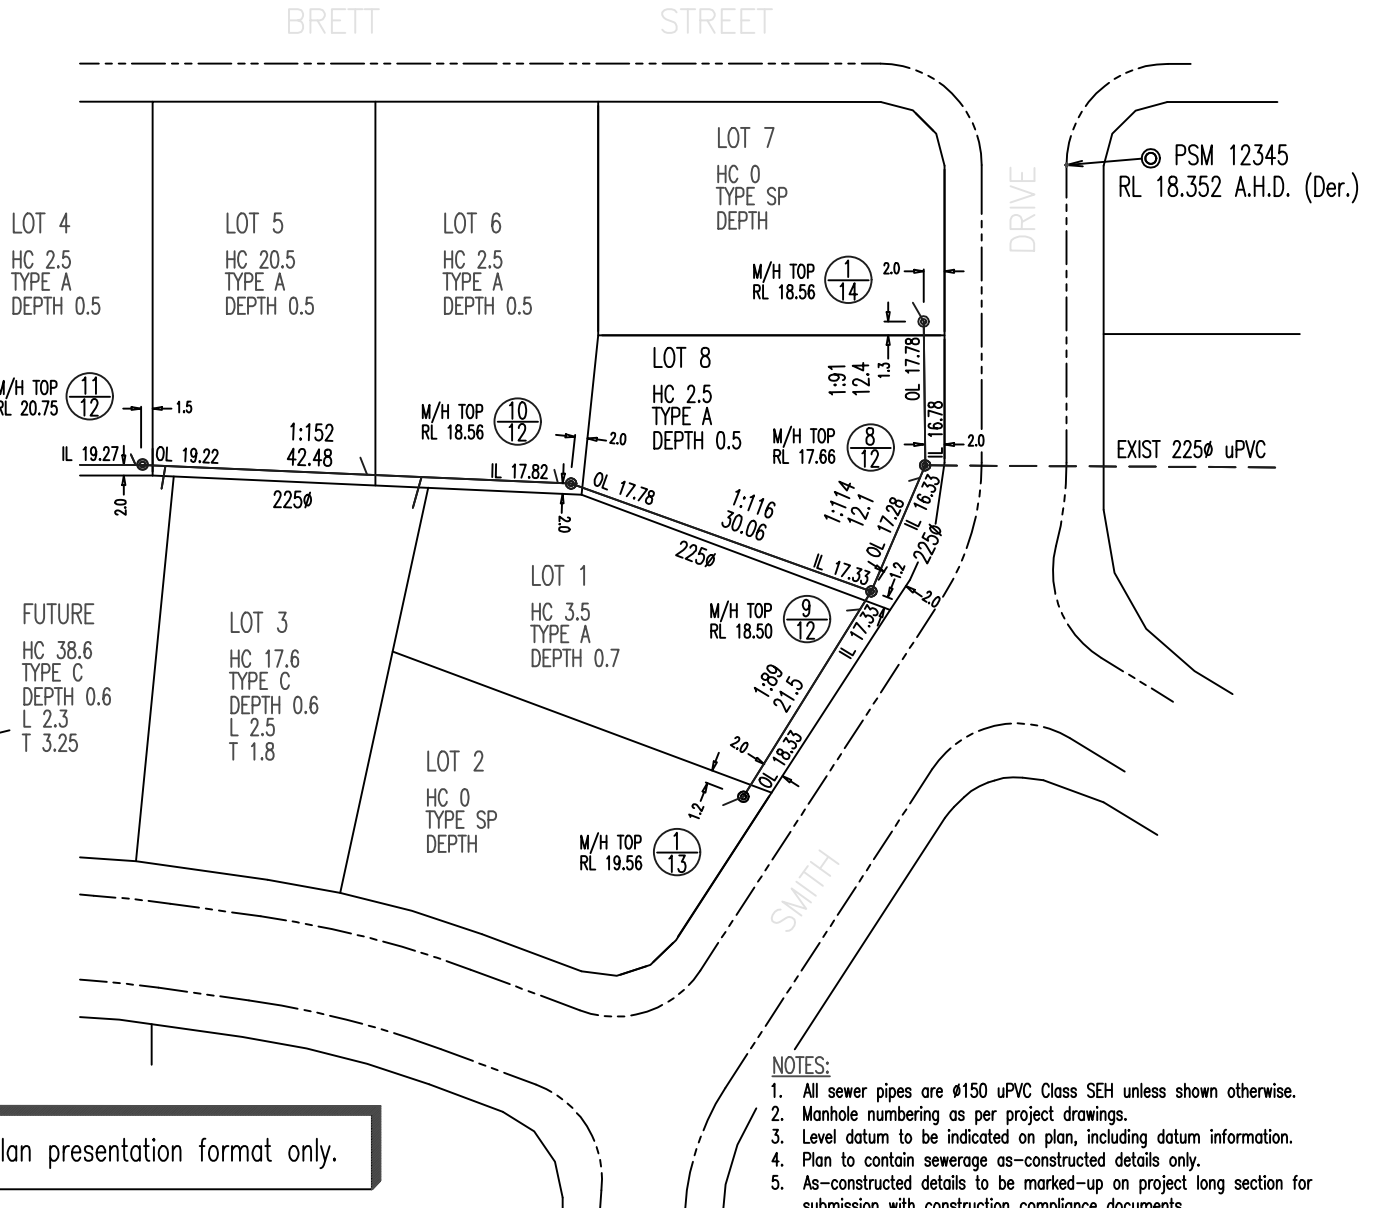

NOTES:

1. All sewer pipes are ϕ 150 uPVC Class SEH unless shown otherwise.
2. Manhole numbering as per project drawings.
3. Level datum to be indicated on plan, including datum information.
4. Plan to contain sewerage as-constructed details only.
5. As-constructed details to be marked-up on project long section for submission with construction compliance documents.

REVISIONS	DATE
D DEVELOPMENT MANUAL UPDATES AND AMENDMENTS 2018	26/10/18
C GENERAL UPDATES AND STANDARD REFERENCING AMENDMENTS	6/5/16
B MINOR AMENDMENTS	10/3/98
A ORIGINAL ISSUE	1/3/97



Email: info@whitsundayrc.qld.gov.au Web: www.whitsundayrc.qld.gov.au

BOWEN
67 Herbert St
Bowen 4805 Q
Ph 07 4761 3600

COLLINSVILLE
Cnr Stanley & Conway Sts
Collinsville 4804 Q
Ph 07 4785 5366

PROSERPINE
83-85 Main St
Proserpine 4800 Q
Ph 07 4945 0200

SAMPLE AS CONSTRUCTED PLAN

SEWERAGE
Standard
Drawing
S-0010

A | B | C | D