

This standard drawing is indicative of plan presentation only.

Chlange	00	20.0	40.0	60.0	80.0	100.0	120.0	120.6
RL	10.25	10.25	10.26	10.27	10.28	10.29	10.30	10.30

FIRST CLOSE LONG SECTION
Scale 1:1000 Hz 1:100 Vt



SECOND

- NOTES:**
- Refer to WRC Development Manual for general as-constructed submission requirements and as-constructed tolerances
 - An ADAC XML file of the as-constructed survey (MGA co-ordinates and AHD heights) to be supplied to Council
 - Any WRC specific attribution for assets that have been captured that are not part of the current ADAC schema are to be added to the Notes Field within the accompanying ADAC XML file
 - An AutoCAD DWG and PDF file of the as-constructed data to be supplied to Council in accordance with the Development Manual requirements
 - All as-constructed information must be approved and signed by a Registered Surveyor and a RPEQ certified engineer in accordance with the Development Manual requirements
 - This sample plan is indicative of plan presentation only.
 - The engineering design plans can be used for presentation of the as-constructed information but the digital data must be correct as per the as-constructed survey (no red line or hand drawn plans will be accepted).
 - All of the elements shown on this sample must be included on the as-constructed plans, unless otherwise directed by Council
 - All footpath and driveway infrastructure to be shown with RLs on this plan if constructed as part of the development
 - Property lot numbers and plan numbers to be shown. Subdivision name/stage/developer/construction company details and DA number to be included where applicable
 - All dimensions in meters
 - All drafting work shall be to AS 1100.101 – Technical drawing
 - Private assets to be clearly identified as separate from WRC assets
 - Where cross section/pavement changes, provide additional typical sections/details
 - Contours to be shown on earth works plans where more detailed grade changes occur
 - Pavement layer asset capture must occur during construction to meet the requirements of the WRC Development Manual and approved ADAC schema

LEGEND

- X 10.75 Reduced Level
- SW Stormwater Pipe
- Kerbing
- - - - - Change of Grade
- ▤ Conc Block Ret Wall

PAVEMENT DETAIL
Scale 1:15

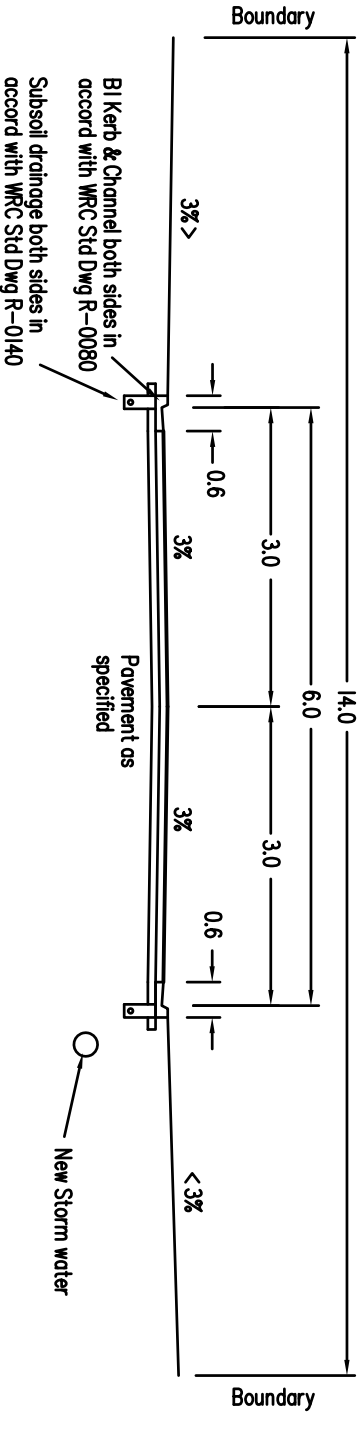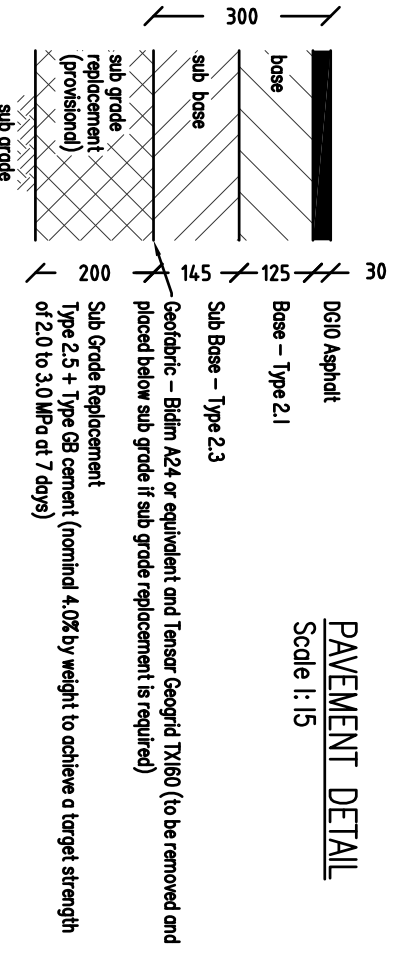

TYPICAL SECTION CH00 TO CH120.6
Scale 1:200

All corresponding Plan views to have their associated longitudinal sections and cross sections on the one sheet. Multiple sheets if development is large.

REVISIONS	DATE
A	22/04/19
ORIGINAL ISSUE	



Whitsunday Regional Council
Email: info@whitsundayrc.qld.gov.au Web: www.whitsundayrc.qld.gov.au

BOWEN
67 Herbert St
Bowen 4800 Q
Ph 07 4761 3600

COLLINSVILLE
Cnr Stanley & Cornwall Sts
Collinsville 4804 Q
Ph 07 4783 5366

PROSERPINE
83-85 Main St
Proserpine 4800 Q
Ph 07 4945 0200

ROADS / EARTHWORKS
SAMPLE AS-CONSTRUCTED PLAN

DRAINAGE
Standard Drawing
R-0020

A			